

# FINAL CLOSURE PLANS ASHBY MUNICIPAL LANDFILL ASHBY, MASSACHUSETTS


PREPARED FOR

TOWN OF ASHBY

PREPARED BY

ASHBY BOARD OF HEALTH

MARY KRAPP - CHAIRPERSON  
CEDWYN MORGAN  
CHRIS ALLEN

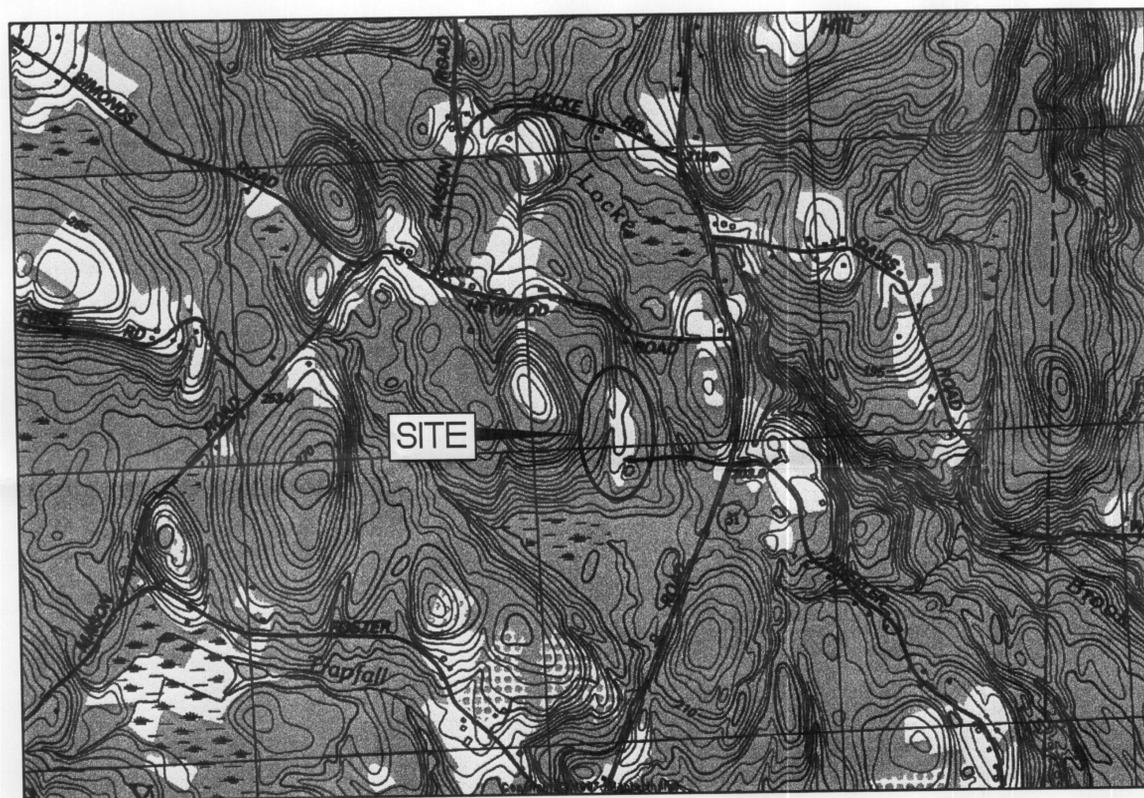

LOCUS PLAN

DRAWINGS PERPARED BY:

**GZA** | GZA  
GeoEnvironmental, Inc.

320 NEEDHAM STREET  
NEWTON UPPER FALLS, MASSACHUSETTS

ENGINEER OF RECORD:

PAUL BERGQUIST, P.E.  
P.O. BOX 28  
ASHBY, MA

## INDEX OF SHEETS:

- C-1. TITLE AND INDEX
- C-2. EXISTING CONDITIONS PLAN (NO CHANGES)
- C-3. PREPARATION GRADING PLAN "AS-BUILT" 12/10/99
- C-3A. TOP OF GAS VENTING SAND PLAN (NO CHANGES)
- C-4. FINAL GRADING AND STORMWATER MANAGEMENT "AS-BUILT" 12/10/99
- C-4A. SURFACING PLAN "AS-BUILT" 12/10/99
- C-5. LANDFILL GAS VENTING SYSTEM "AS-BUILT" 12/10/99
- C-6. SECTIONS AND DETAILS (NO CHANGE)
- C-7. DETAILS, AND NOTES "AS-BUILT" 12/10/99
- C-8. ENVIRONMENTAL MONITORING PLAN (NO CHANGE)
- C-9. EROSION AND SEDIMENT CONTROL DETAILS (NO CHANGE) AND NOTES

PROJECT NO.  
15729

DRAWING NO.

C-1

THIS DRAWING HAS BEEN PREPARED IN ELECTRONIC FORMAT. CLIENT MAY BE PROVIDED COPIES OF DRAWINGS AND SPECIFICATIONS ON MAGNETIC MEDIA FOR THEIR INFORMATION AND USE FOR SPECIFIC APPLICATION TO THIS PROJECT. DUE TO THE POTENTIAL THAT THE MAGNETIC INFORMATION MAY BE ACCESSED INDIVIDUALLY OR OTHERWISE, GZA GEOENVIRONMENTAL, INC. (GZA) MAY DENY ALL RIGHTS IN THIS DOCUMENT'S AUTHORSHIP ON THE MAGNETIC MEDIA. PRINTED REPRESENTATIONS OF THE DRAWINGS AND SPECIFICATIONS SHALL BE THE ONLY RECORD COPIES OF GZA'S WORK PRODUCT. ANY USE OF THIS DOCUMENT PRODUCED FROM MAGNETIC MEDIA WITHOUT VERIFICATION OR ADAPTATION BY GZA FOR THE SPECIFIC USE INTENDED WILL BE THE USER'S SOLE RESPONSIBILITY AND WITHOUT THIS DOCUMENT TO GZA GEOENVIRONMENTAL, INC. BY ACCEPTING THIS DOCUMENT IN MAGNETIC MEDIA FORMAT, CLIENT AGREES TO RELEASE AND HOLD HARMLESS GZA GEOENVIRONMENTAL, INC. FROM ALL CLAIMS FOR DAMAGES, LOSSES AND EXPENSES ARISING OUT OF OR RESULTING FROM THE USE OR MISUSE OF THIS ELECTRONIC DOCUMENT.