© 1999 GZA GeoEnvironmental, Inc.

RAW, 07/07/1999, 16:32:15 | XREFS: X-BASE=13300E34, X-EX=13300X11, X-F04=13300F04, X-FNL=13300G21, X-GAS=13300GAS, X-PERIM=13300P21, X-SEC=13300SC1, X-TB=13300TB | PCP: GZA | FILE: G:\15729.1N5\15729-00.SJT\FIGURES\6-25-99\13300F05.DWG

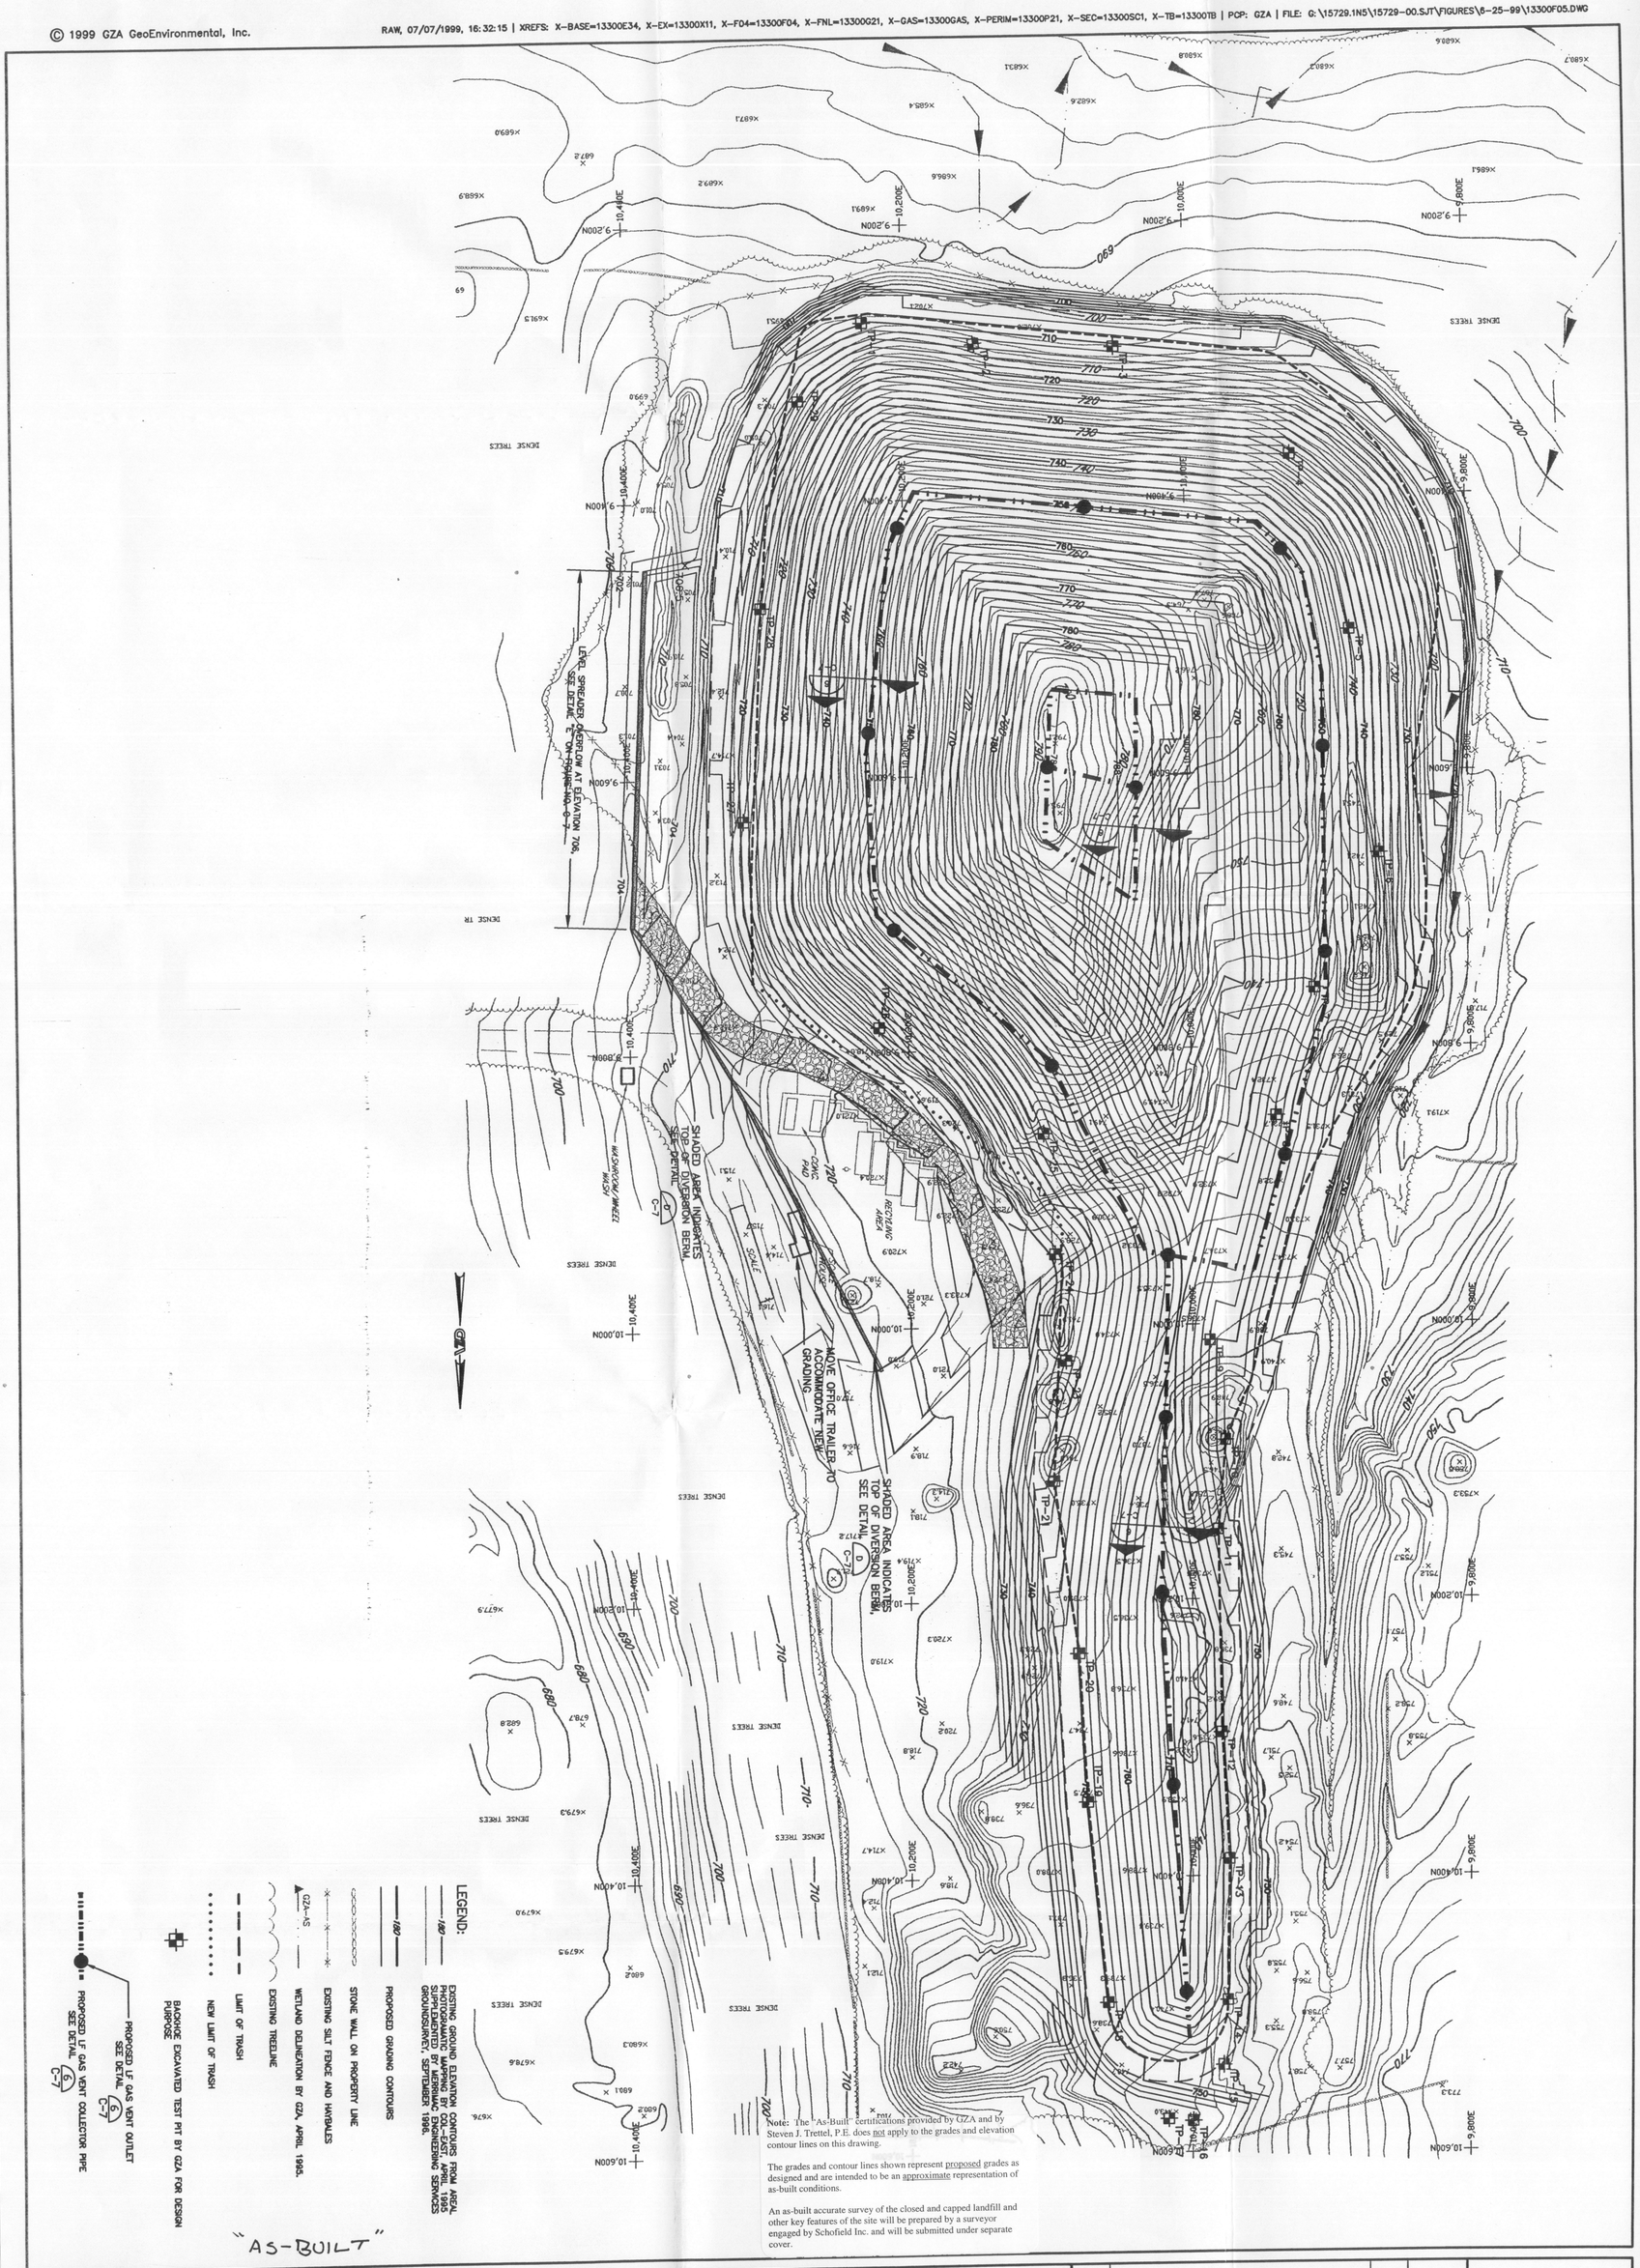

Note: The "As-Built" certifications provided by GZA and by Steven J. Trettel, P.E. does not apply to the grades and elevation contour lines on this drawing.

The grades and contour lines shown represent proposed grades as designed and are intended to be an approximate representation of as-built conditions.

An as-built accurate survey of the closed and capped landfill and other key features of the site will be prepared by a surveyor engaged by Schofield Inc. and will be submitted under separate cover.

FINAL CLOSURE PLANS ASHBY MUNICIPAL LANDFILL ASHBY, MASSACHUSETTS	DESIGNED BY: RAW CHECKED BY: SJT REVIEWED BY: SJT DRAWN BY: RAW SCALE: AS NOTED DATE: JUNE 9, 1999	0 25' 50' 100'	
LANDFILL GAS VENTING SYSTEM		GZA GeoEnvironmental, Inc.	

REV#	DESCRIPTION	BY	DATE
1	GAS VENT SYSTEM (TOP OF LANDFILL) INSTALLED AT LOCATION SHOW. SEE CHANGE C-7 DETAIL 5.	DJS	12/10/99

PROJECT NO. 15729

FIGURE NO. C-5